


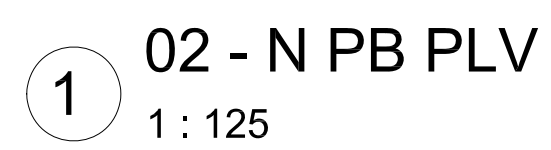


Map showing the location of the project on Avenida Ramón Corchero, between Avenida 100 and Avenida 101, near the intersection with Avenida 102. The map includes a north arrow and labels for 'SOARE I', 'SOARE II', and 'SOLARES'.

 FIBERMOUSE TRO
 NORMA
 CED-40
 COLADERA
 MODA
 CF  INDICADO
 BAJANTE DE
 BAP  AGUAS
 PLUVIALES

ccossaro@csarquitectos.com
dstetis@csarquitectos.com
www.csarquitectos.com



	Instalaciones Plásticas S.A. de C.V.	Calle: San Jorge No. 362, Col. Las Lomas C.P. 46500 Tlaquepaque, Jalisco Tel. 01 (33) 3670.90.42 Fax: 01 (33) 3670.97.86 email: ventas@induplast.com
	PROPIETARIO: <div style="text-align: center; font-size: 1.5em; font-weight: bold;">VILLA PLATA</div>	
UBICACIÓN: <div style="text-align: center; font-size: 1.5em; font-weight: bold;">ZAPOPAN, JALISCO</div>		
CONTENIDO: <div style="text-align: center; font-size: 1.5em; font-weight: bold;">INSTALACION PLUVIAL PLANTA BAJA</div>	CLAVE: <div style="text-align: center; font-size: 1.5em; font-weight: bold;">IP-02</div>	
REVISÓ: <div style="text-align: center; font-size: 1.5em; font-weight: bold;">ING.J.C.S.A.</div>	DEBUIÓ: <div style="text-align: center; font-size: 1.5em; font-weight: bold;">ING.A.A.V.S.</div>	PROYECTO: <div style="text-align: center; font-size: 1.5em; font-weight: bold;">ING.M.G.G.</div>
FECHA: <div style="text-align: center; font-size: 1.5em; font-weight: bold;">2018-2019</div>	ESCALA: <div style="text-align: center; font-size: 1.5em; font-weight: bold;">1 : 125</div>	HOJA: <div style="text-align: center; font-size: 1.5em; font-weight: bold;">02</div>